


GROUND FLOOR

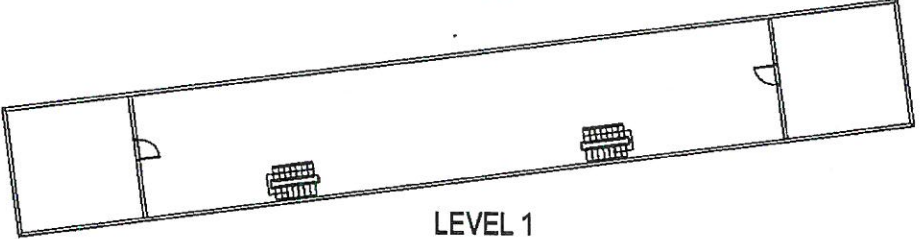

LEVEL 1

Return to Site Plan

REV.	DATE	DESCRIPTION
A	06.12.2013	AS BUILT

**SITE: LITHGOW CORRECTIONAL CENTRE  
LITHGOW N.S.W**

**FACILITY NUMBER: 719**  
**BUILDING CODE: 014 - E Block / Segregation Cells**

**UPDATED BY: ADN**  
Contact Details: Phone: 02 4322 0766  
Email: nell@inson@edn.com.au

**DATE: 04.12.2013**  
**SCALE: N.T.S**

